

Derby Industrial Museum

Railway Drawings Recording Form

Record number 1971-384/538

Previous Record number

CATTELL
1070

Title BOROUGH OF BURTON ON TRENT
 IN THE COUNTIES OF STAFFORD & DERBY.

Brief Description

Map of Burton on Trent showing whole town up to 2 1/4 mile radius centred on site of new station.

Tables of: Reference to Breweries - 30 companies.
 Details of Town & Council.
 Public Buildings.

Proposed route of Burton/Stapenhill pedestrian bridge shown.

Permanent location DBYIM & room 49 & shelf: 118

Dimensions (mm) length: 720 width: 970

Material Paper

Condition good / fair / poor

Completeness complete / incomplete

Original drawing number

Company:

Scale: 1" = 220 yds

Person: J A Mason

Date: Sept 1879

Estate Agent & Surveyor
Burton on Trent

Place:

Burton on Trent

Classified category: 4. 721. 301. 205A, ~~205A~~, 75C

Recorder: *AMM* 23/5/03

219A	220A
219B	220B
219C	220C
221A	222A
221B	222B
221C	222C
221D	222D
221E	222E

Derby Industrial Museum

Railway Drawings Recording Form

Record number 1971-384/540.1

Previous Record number CATTELL
1083

Title

Brief Description

Plan showing route of railway
from Shobnall Wharf to Bond End Wharf
crossing under main line, & part of branch
off to James Street from Usbridge Street Junction.
Track line shows continuation from Bond End
across Fleet Green

Permanent location DBYIM & room 49 & shelf: 118

Dimensions (mm) length: 2870 width: 860

Material tracing paper on paper on fabric

Condition good / fair / poor

Completeness complete / incomplete

Original drawing number

Company:

Scale: 1" = 1 CHAIN Person:

Date: May 29th, 1880

Place:

Burton on Trent.

Classified category: 4. 721. 301. 221C, 221A, 221D 205A, 220C,

Recorder:

May 23/5/2003

Derby Industrial Museum

Railway Drawings Recording Form

CATTELL

Record number 1971-384/291.1

Previous Record number 1024

Title

Good End Branch

Brief Description

Plan of part of town with Council off ~~A~~ MR line crossing James Street and towards Ardwick Street (Ladies Walkings, ~~brewery~~, and ~~bars~~) Other streets shown: Park Street, Birchfield Street, New Street, Unbridge Street. Premises shown: Ladies Walkings, Everheds Walkings, Thornevall & Warham, Bindleys Brewery, Everheds Brewery, Robinson & Co's Brewery.

Faint pencil line for new track from branch line (James Street ~~bars~~, Belle, Everheds & Robinsons.)

Permanent location DBYIM & room 49 & shelf 113

Dimensions (mm) length: 1000 width: 675

Material Paper on folio

Condition good / fair / poor

Completeness complete / ~~incomplete~~

Original drawing number I 78

Company: MR

Scale: 1" = 100000 Person:

Date:

Place:

Barton on Trent


Classified category: 4.721.301. 221C, 221D, 221A, 222A.

Recorder

1146 21/12/2001

1971-384/291.1

New route

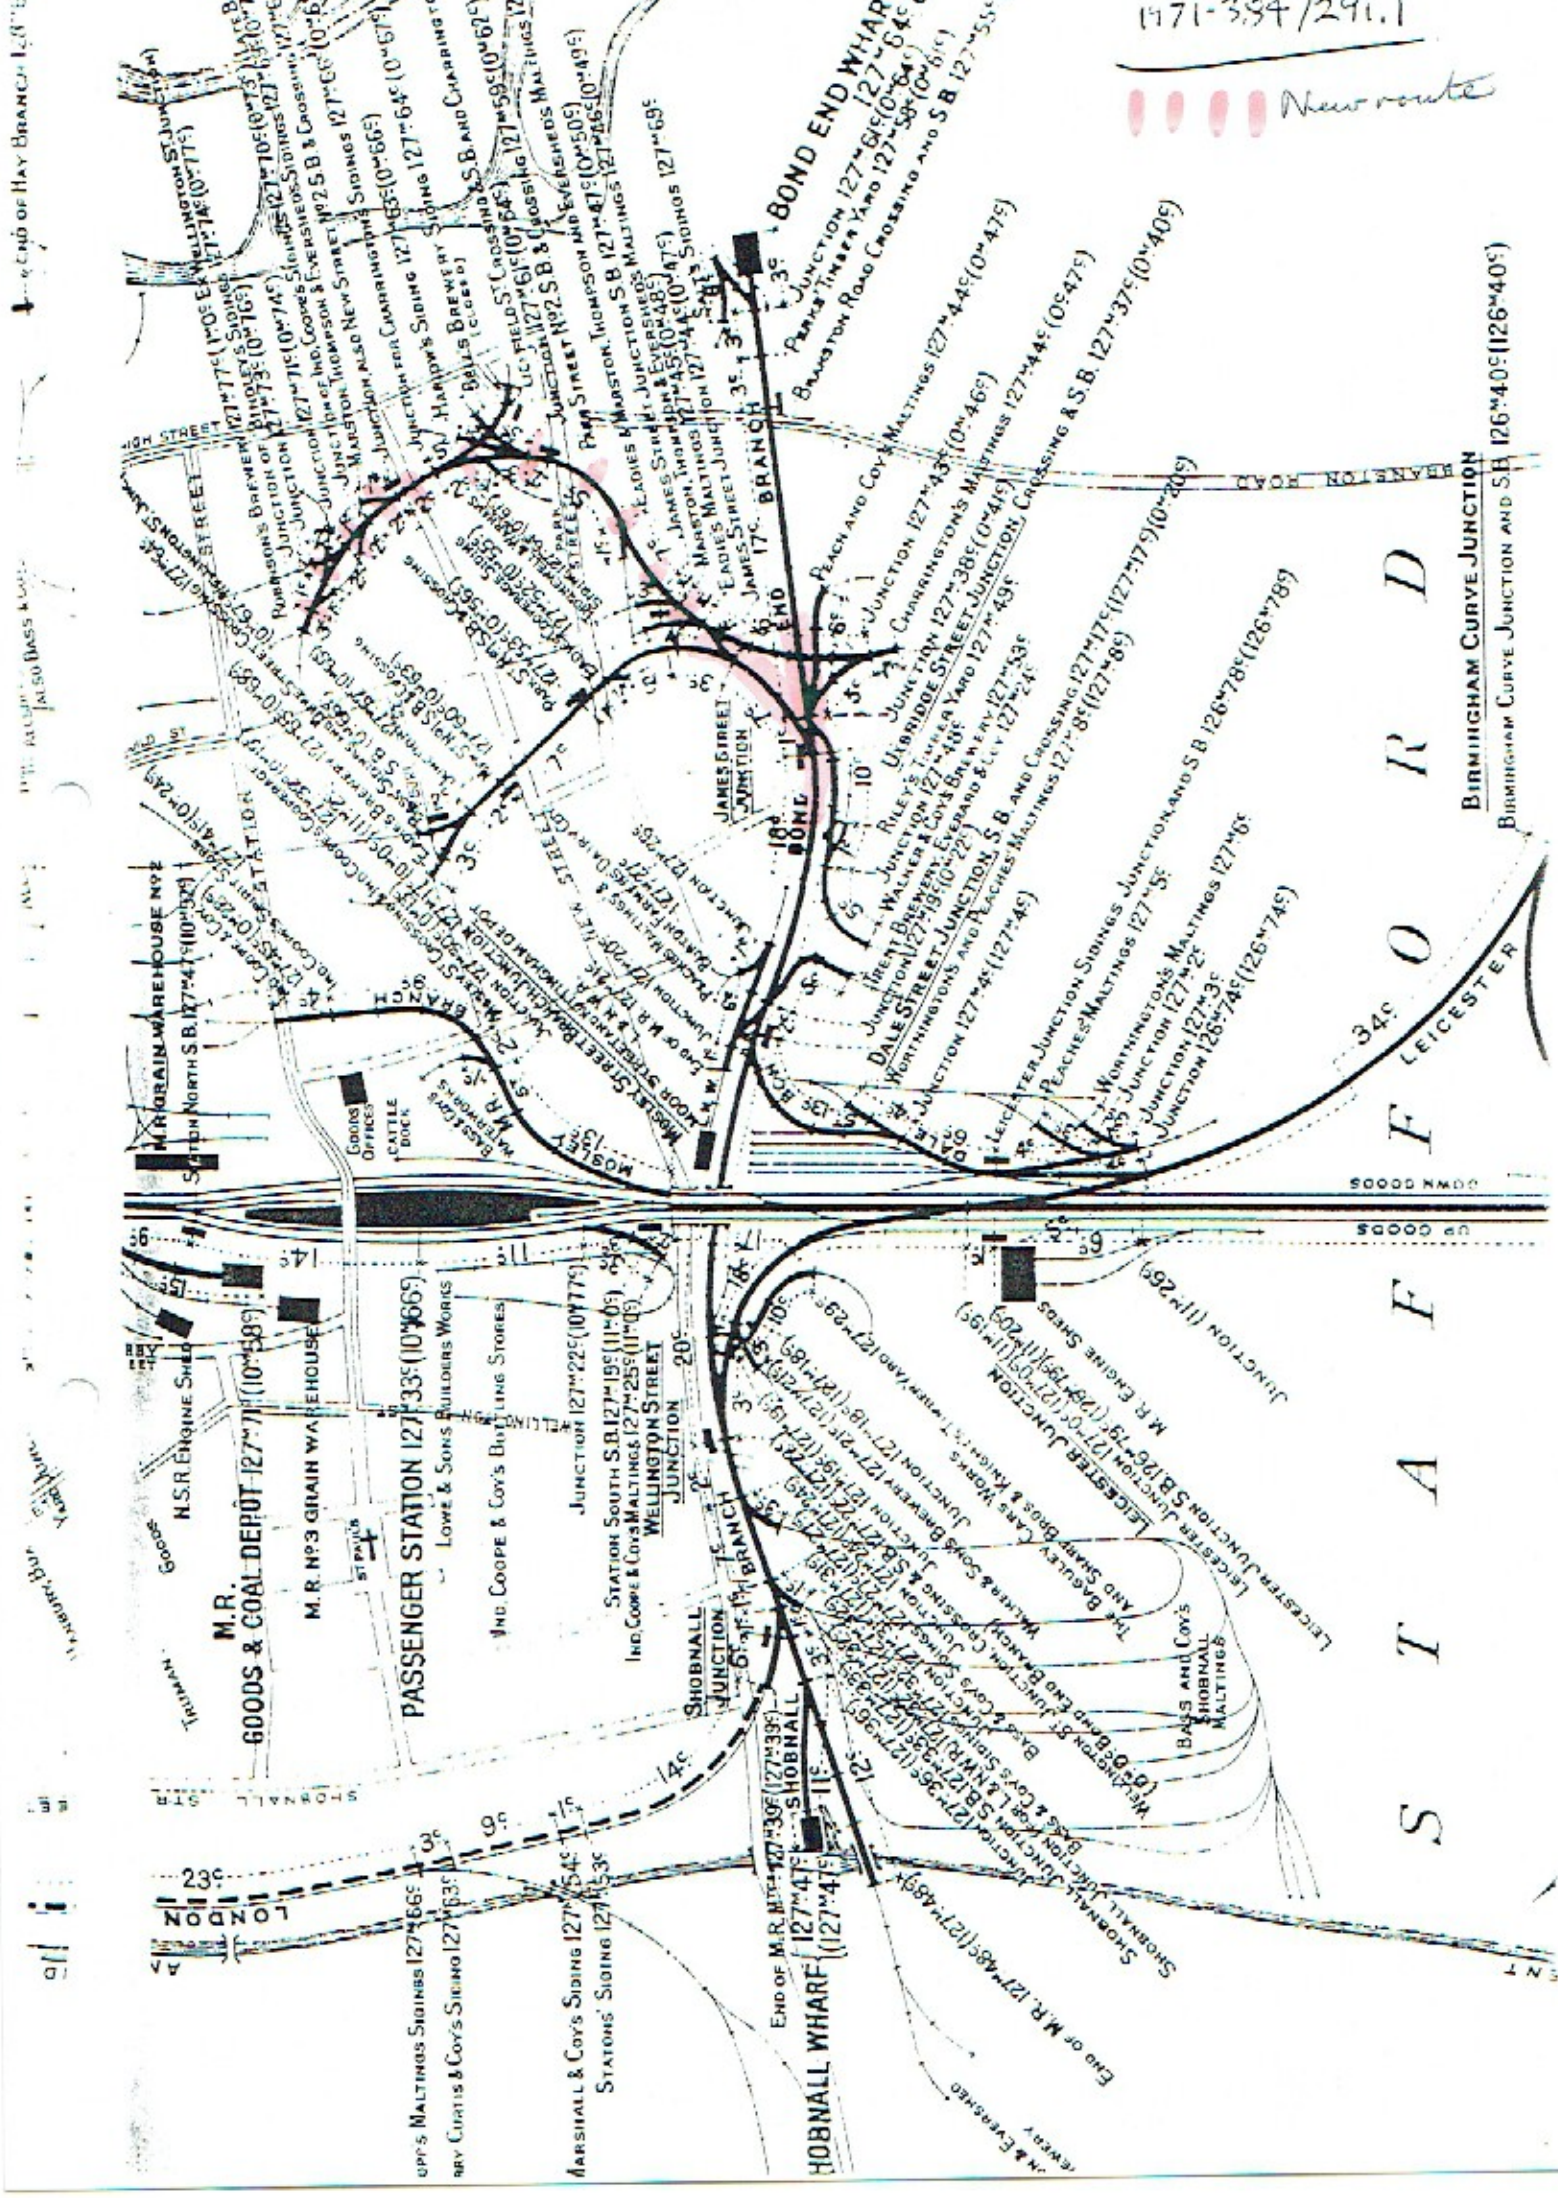

S T A F F O R D
 BIRMINGHAM CURVE JUNCTION AND S.B. 126°40' (126°40'9)
 BIRMINGHAM CURVE JUNCTION AND S.B. 126°40' (126°40'9)


Derby Industrial Museum

Railway Drawings Recording Form

Record number 1971-384/293

Previous Record number

6197722
1029

Title

Brief Description

Large scale map showing line from
Bond End to Sharnhall, shaded red, and
branches off it. Attached map shows
Act of 1874, solid red. Existing lines from
1836/60/64/78 in broken red.

Proposed route Burton Connecting Branch Act 1875
in fine red chain.

Adjacent properties, roads, watercourses and
boundaries shown.

Permanent location DBYIM & room 49 & shelf: 113

Dimensions (mm) length: 2730 width: 750

Material Paper on vellum

Condition good / fair / poor

Completeness complete / incomplete

Original drawing number

Company: M.R.

Scale: ~~2 1/2" = 1 chain~~ 1" = 1 chain Person:


Date: May 22, 1880

Place:

Burton on Trent.

Classified category: 4.721.301. 220B, 220C, 221A, 221C, 221D.

Recorder: *[Signature]* 21/2/2001

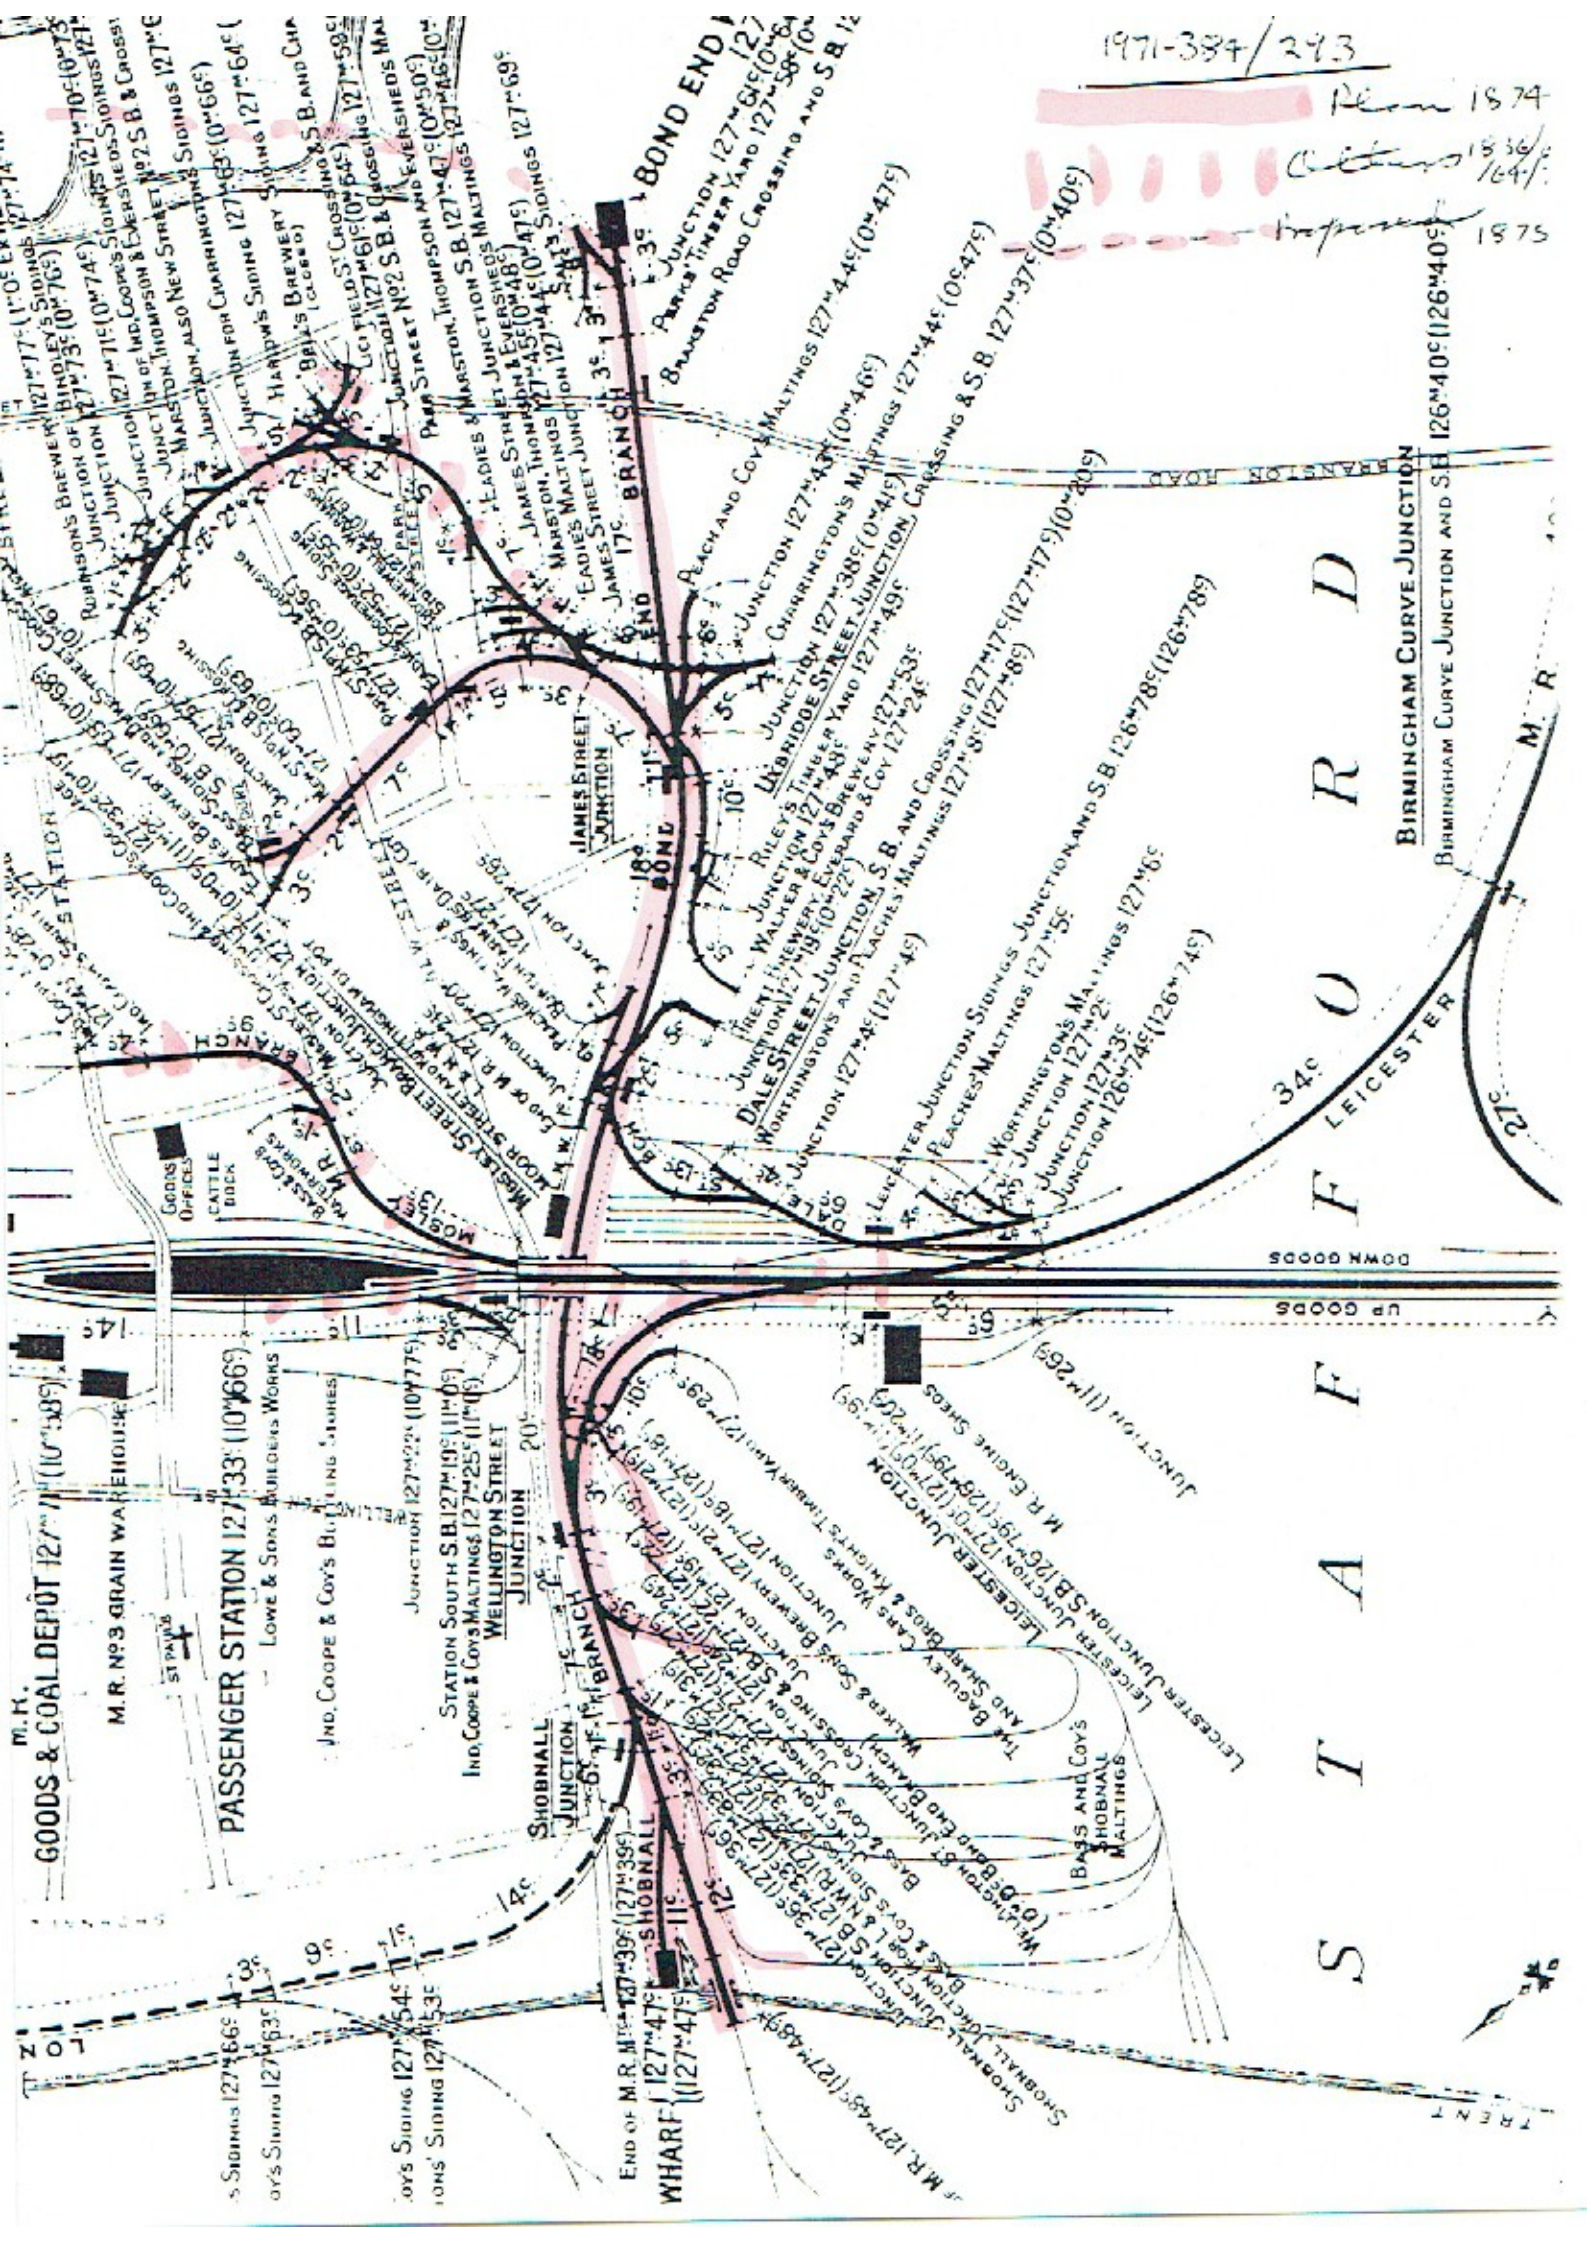

M.H.
GOODS & COAL DEPOT 127° 11' (10° 38')
 M.R. No. 3 GRAIN WAREHOUSE
 ST PAVES

PASSENGER STATION 127° 33' (10° 66')
 Lowe & Sons Builders Works
 Ind. Coope & Coy's BUILDING SHEDS

Ind. Coope & Coy's BUILDING SHEDS
 STATION SOUTH S.B. 127° 19' (11° 0')
 Ind. Coope & Coy's MALTINGS 127° 25' (11° 0')
WELLINGTON STREET JUNCTION 20'

SHOBHALL JUNCTION
 SHOBHALL BRANCH


LEICESTER JUNCTION
 M.R. ENGINE SIDES
 LEICESTER JUNCTION S.B. 126° 19' (12° 05')


S T A F F O R D

BIRMINGHAM CURVE JUNCTION
 BIRMINGHAM CURVE JUNCTION AND S.B. 126° 40' (126° 40')



UP GOODS
 DOWN GOODS

